
STATE OF ILLINOIS DEPARTMENT OF TRANSPORTATION



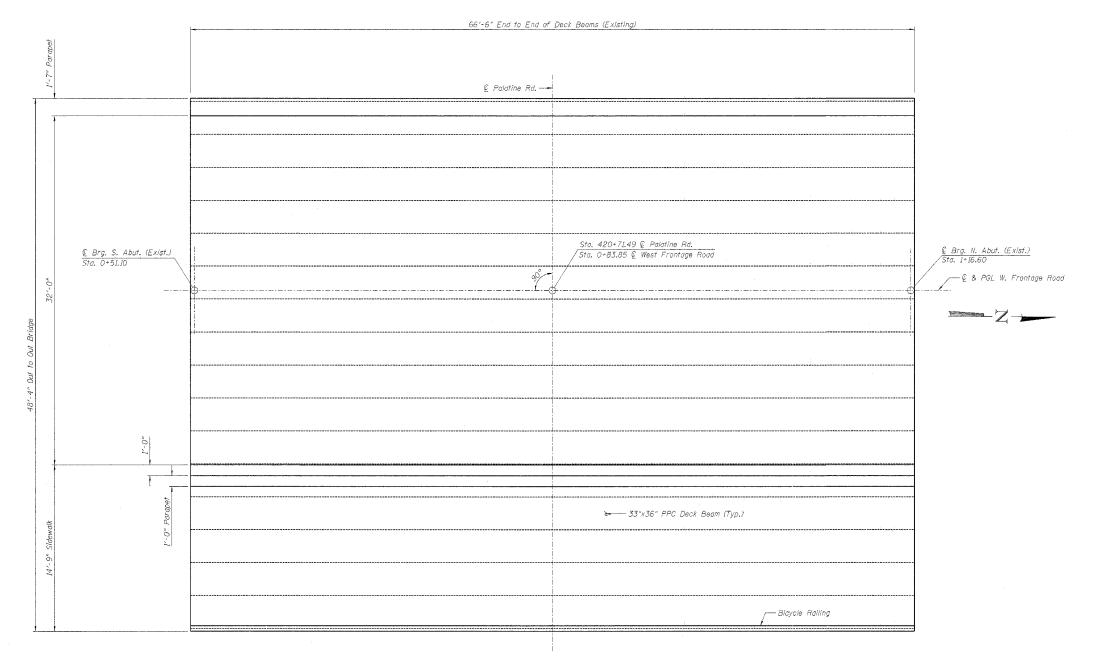

AS BUILT PLAN OF CONCRETE DECK BEAM REPAIRS TOP VIEW

NOTE

BRANCO & ZROKA ENGINEERING, P.C.

DESIGNED LAS

CHECKED DAZ

DRAWN SAW

CHECKED LAS

February 2005

After removal of the biruminous overlay, any areas with delamination extending to the top mai of reinforcement on the beam shall be cleaned of any loose concrete and filled back up with the concrete overlay. Any area where the damage extends below the top mat of reinforcement on the beam shall be brought to the attention of the Bureau of Bridges and Structures for further disposition. Work included in the cost of "Concrete Wearing Surface."

CONCRETE DECK BEAM REPAIRS I
WEST FRONTAGE ROAD OVER PALATINE ROAD

FAP 305/PALATINE ROAD

SECTION 2004-108 BR

COOK COUNTY

STA. 0+88.97

STRUCTURE NO. 016-2530